



SEAL:

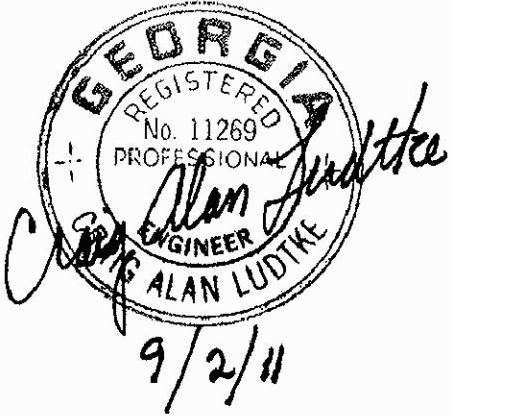

**STABILITY ENGINEERING 2ND FLOOR
 FEASIBILITY STUDY AND MARKUP
 SE#20576 DATE: 1/12/2021**

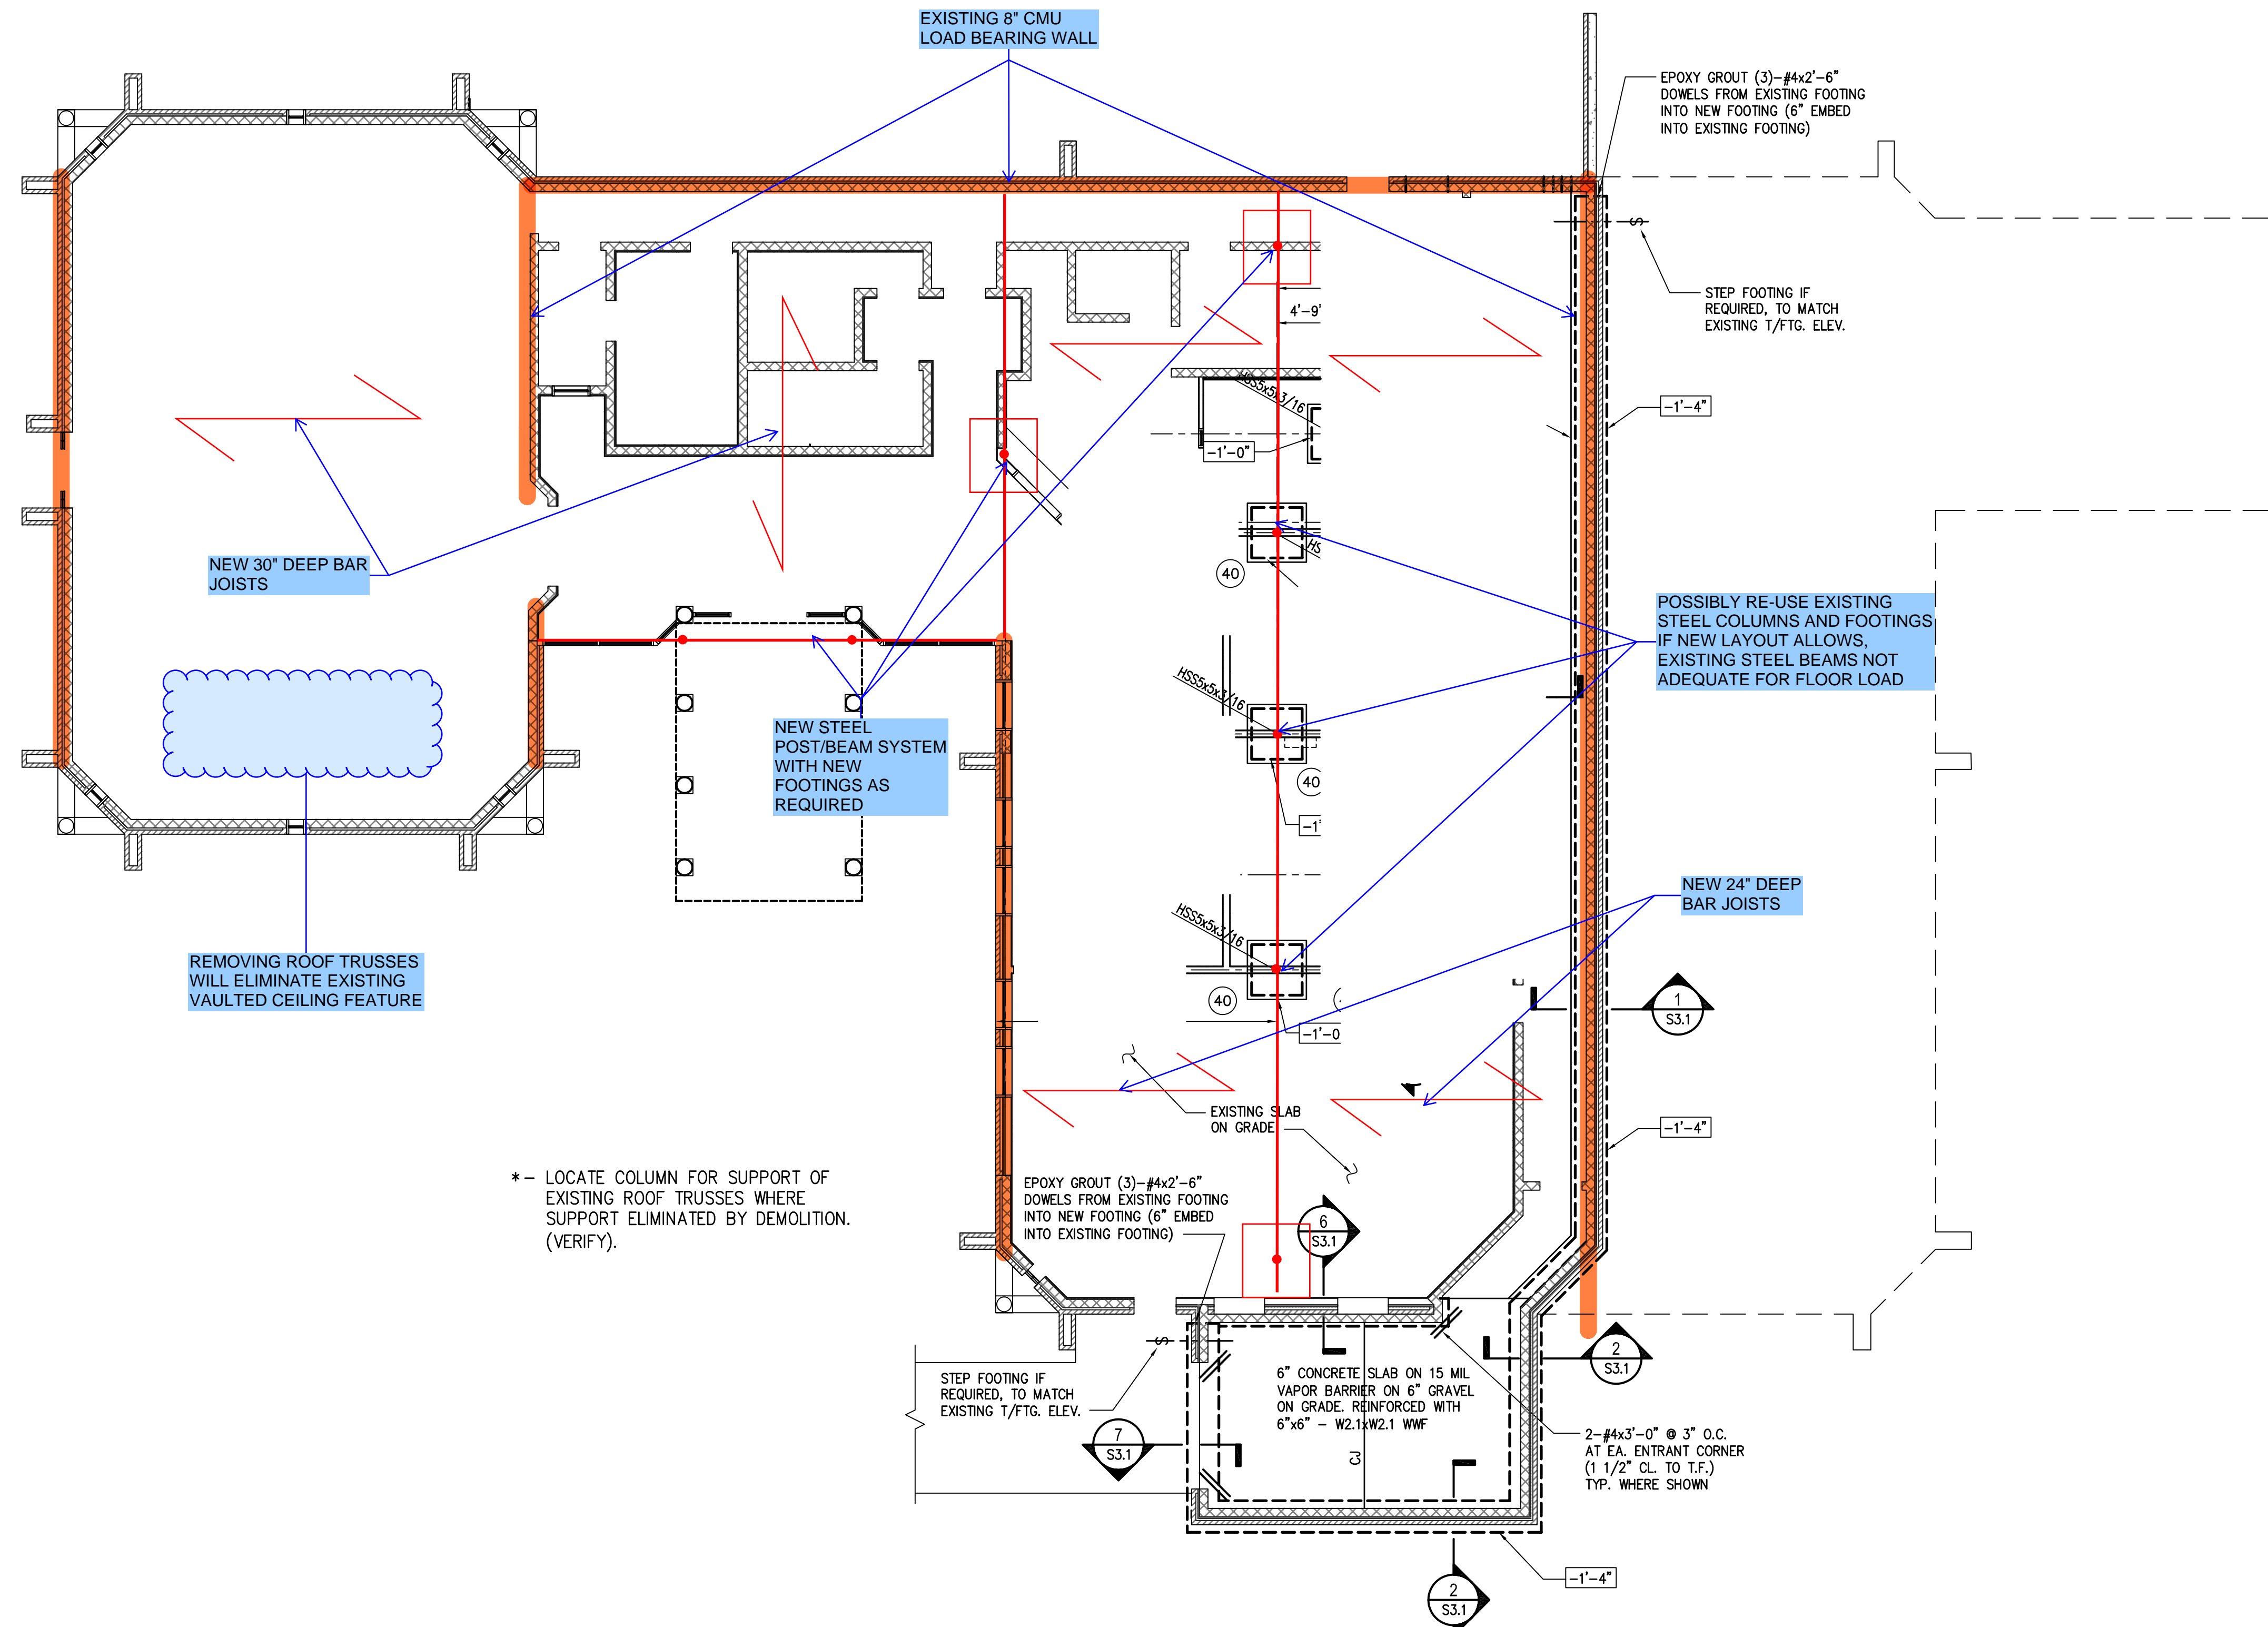

1 SLAB AND FOUNDATION PLAN
 SCALE: 1/8"=1'-0"

- PLAN NOTES:
- SEE SHEET S3.1 FOR SLAB ON GRADE CONTROL JOINT DETAIL.
 - SEE SHEET S3.1 FOR FOOTING STEP DETAIL, AS REQUIRED.
 - INDICATES TOP OF FOOTING ELEVATION.

FOOTING SCHEDULE		
MARK	SIZE & REINFORCEMENT	REMARKS
(40)	4'-0"x4'-0"x1'-3" W/ 5# EACH WAY, BTM.	

**MUNICIPAL COURT BUILDING
 FOR CITY OF POWDER SPRINGS, GA.
 RENOVATION OF POLICE/MUN. COURT BLDG.
 4483 PINEVIEW DRIVE
 POWDER SPRINGS, GEORGIA**

REVISIONS:

SYMBOL	DATE	REVISION
	9/6/11	PRICING SET

PROJECT NO.	
DESIGNED BY	CL
DRAWN BY	VI
CHECKED BY	PCS
REVIEWED BY	PCS
SCALE	AS SHOWN

**SLAB
 AND
 FOUNDATION
 PLAN**

**SHEET NUMBER
 S1.1**